



DEPARTMENT OF REGULATORY AND ECONOMIC RESOURCES (RER)
BOARD AND CODE ADMINISTRATION DIVISION

NOTICE OF ACCEPTANCE (NOA)

MIAMI-DADE COUNTY
PRODUCT CONTROL SECTION
11805 SW 26 Street, Room 208
Miami, Florida 33175-2474
T (786) 315-2590 F (786) 315-2599
www.miamidade.gov/economy

Haas Door Company
320 Sycamore Street
Wauseon, OH 43567

SCOPE: This NOA is being issued under the applicable rules and regulations governing the use of construction materials. The documentation submitted has been reviewed and accepted by Miami-Dade County RER-Product Control Section to be used in Miami Dade County and other areas where allowed by the Authority Having Jurisdiction (AHJ). This NOA shall not be valid after the expiration date stated below. The Miami-Dade County Product Control Section (In Miami Dade County) and/or the AHJ (in areas other than Miami Dade County) reserve the right to have this product or material tested for quality assurance purposes. If this product or material fails to perform in the accepted manner, the manufacturer will incur the expense of such testing and the AHJ may immediately revoke, modify, or suspend the use of such product or material within their jurisdiction. RER reserves the right to revoke this acceptance, if it is determined by Miami-Dade County Product Control Section that this product or material fails to meet the requirements of the applicable building code.

This product is approved as described herein, and has been designed to comply with the Florida Building Code, including the High Velocity Hurricane Zone.

DESCRIPTION: Series HT 600, 700, 800 & 2000 Insulated Steel Sectional Garage Door up to 18'-2" Wide

APPROVAL DOCUMENT: Drawing No. WL-0600-0218-08-45-50M-D, titled "18'-2" HT 600, 700, 2000 & 800 Steel Series HVHZ Wind Load Sectional Door", sheets 1 through 3 of 3, dated 01/08/2015, prepared by Haas Door Company, signed and sealed by Thomas D. Sullivan, P.E., bearing the Miami-Dade County Product Control approval stamp with the Notice of Acceptance number and approval date by the Miami-Dade County Product Control Section.

MISSILE IMPACT RATING: Large and Small Missile Impact Resistant

LABELING: A permanent label with the manufacturer's name or logo, manufacturing address, model number, the positive and negative design pressure rating, indicate impact rated if applicable, installation instruction drawing reference number, approval number (NOA), the applicable test standards, and the statement reading 'Miami-Dade County Product Control Approved' is to be located on the door's side track, bottom angle, or inner surface of a panel.

RENEWAL of this NOA shall be considered after a renewal application has been filed and there has been no change in the applicable building code negatively affecting the performance of this product.

TERMINATION of this NOA will occur after the expiration date or if there has been a revision or change in the materials, use, and/or manufacture of the product or process. Misuse of this NOA as an endorsement of any product, for sales, advertising or any other purposes shall automatically terminate this NOA. Failure to comply with any section of this NOA shall be cause for termination and removal of NOA.

ADVERTISEMENT: The NOA number preceded by the words Miami-Dade County, Florida, and followed by the expiration date may be displayed in advertising literature. If any portion of the NOA is displayed, then it shall be done in its entirety.

INSPECTION: A copy of this entire NOA shall be provided to the user by the manufacturer or its distributors and shall be available for inspection at the job site at the request of the Building Official. This NOA consists of this page 1 and evidence page E-1, as well as approval document mentioned above. The submitted documentation was reviewed by Carlos M. Utrera, P.E.

MIAMI-DADE COUNTY
APPROVED

Carlos M. Utrera
02/04/2016

NOA No. 15-1104.04
Expiration Date: February 11, 2021
Approval Date: February 11, 2016
Page 1

NOTICE OF ACCEPTANCE: EVIDENCE SUBMITTED

A. DRAWINGS

1. Drawing No. **WL-0600-0218-08-45-50M-D**, titled "18'-2" HT 600, 700, 2000 & 800 Steel Series HVHZ Wind Load Sectional Door", sheets 1 through 3 of 3, dated 01/08/2015, prepared by Haas Door Company, signed and sealed by Thomas D. Sullivan, P.E.

B. TESTS

1. Test reports on 1) Uniform Static Air Pressure Test, Loading per FBC TAS 202-94
2) Large Missile Impact Test per FBC, TAS 201-94
3) Cyclic Wind Pressure Loading per FBC, TAS 203-94
4) Forced Entry Resistance Test, per TAS 202-94
along with marked-up drawings and installation diagram of 16'-2" wide x 8" height HT 600 Series Sectional Steel Garage Doors, prepared by Intertek/ATI, Test Report No. **E1289.03-550-18**, dated 12/22/2014, signed and sealed by Justin P. McDonald, P.E.
2. Test report on Tensile Test per ASTM E8, of steel sheets, prepared by Intertek/ATI, Test Report No. **E1289.11-106-18**, dated 12/12/2014, signed and sealed by Gary T. Hartman, P.E.
3. Test report on Salt Spray per ASTM B117 of coated metal steel panels, prepared by Intertek/ATI, Test Report No. **E1289.10-106-18**, dated 11/24/2014, signed and sealed by Gary T. Hartman, P.E.

C. CALCULATIONS

1. Anchor calculations prepared by JB&B Engineering Consultants, LLC, dated 07/01/2015, signed and sealed by Thomas D. Sullivan, P.E.

D. QUALITY ASSURANCE

1. Miami-Dade Department of Regulatory and Economic Resources (RER)

E. MATERIAL CERTIFICATIONS

1. Test report on Surface Burning Characteristics of the polyurethane foam insulation per ASTM E84, prepared by QAI Laboratories, Test Report No. **RJ3298-1**, dated 06/25/2014, signed by Christopher W.C. Bowness, P.E.
2. Test report on Ignition Temperature of Plastics of the polyurethane foam insulation per ASTM D1929, prepared by QAI Laboratories, Test Report No. **RJ3298-2**, dated 07/14/2014, signed by Christopher W.C. Bowness, P.E.

F. STATEMENTS

1. Statement letter of code conformance to the 5th edition (2014) FBC issued by JB&B Engineering Consultants, LLC, dated 06/16/2015, signed and sealed by Thomas D. Sullivan, P.E.
2. Statement letter of no financial interest issued by JB&B Engineering Consultants, LLC, dated 06/16/2015, signed and sealed by Thomas D. Sullivan, P.E.


02/09/2016
Carlos M. Utrera, P.E.


Product Control Examiner

NOA No. 15-1104.04

Expiration Date: February 11, 2021

Approval Date: February 11, 2016

REVISIONS				
REV.	ZONE	BY	DESCRIPTION	DATE

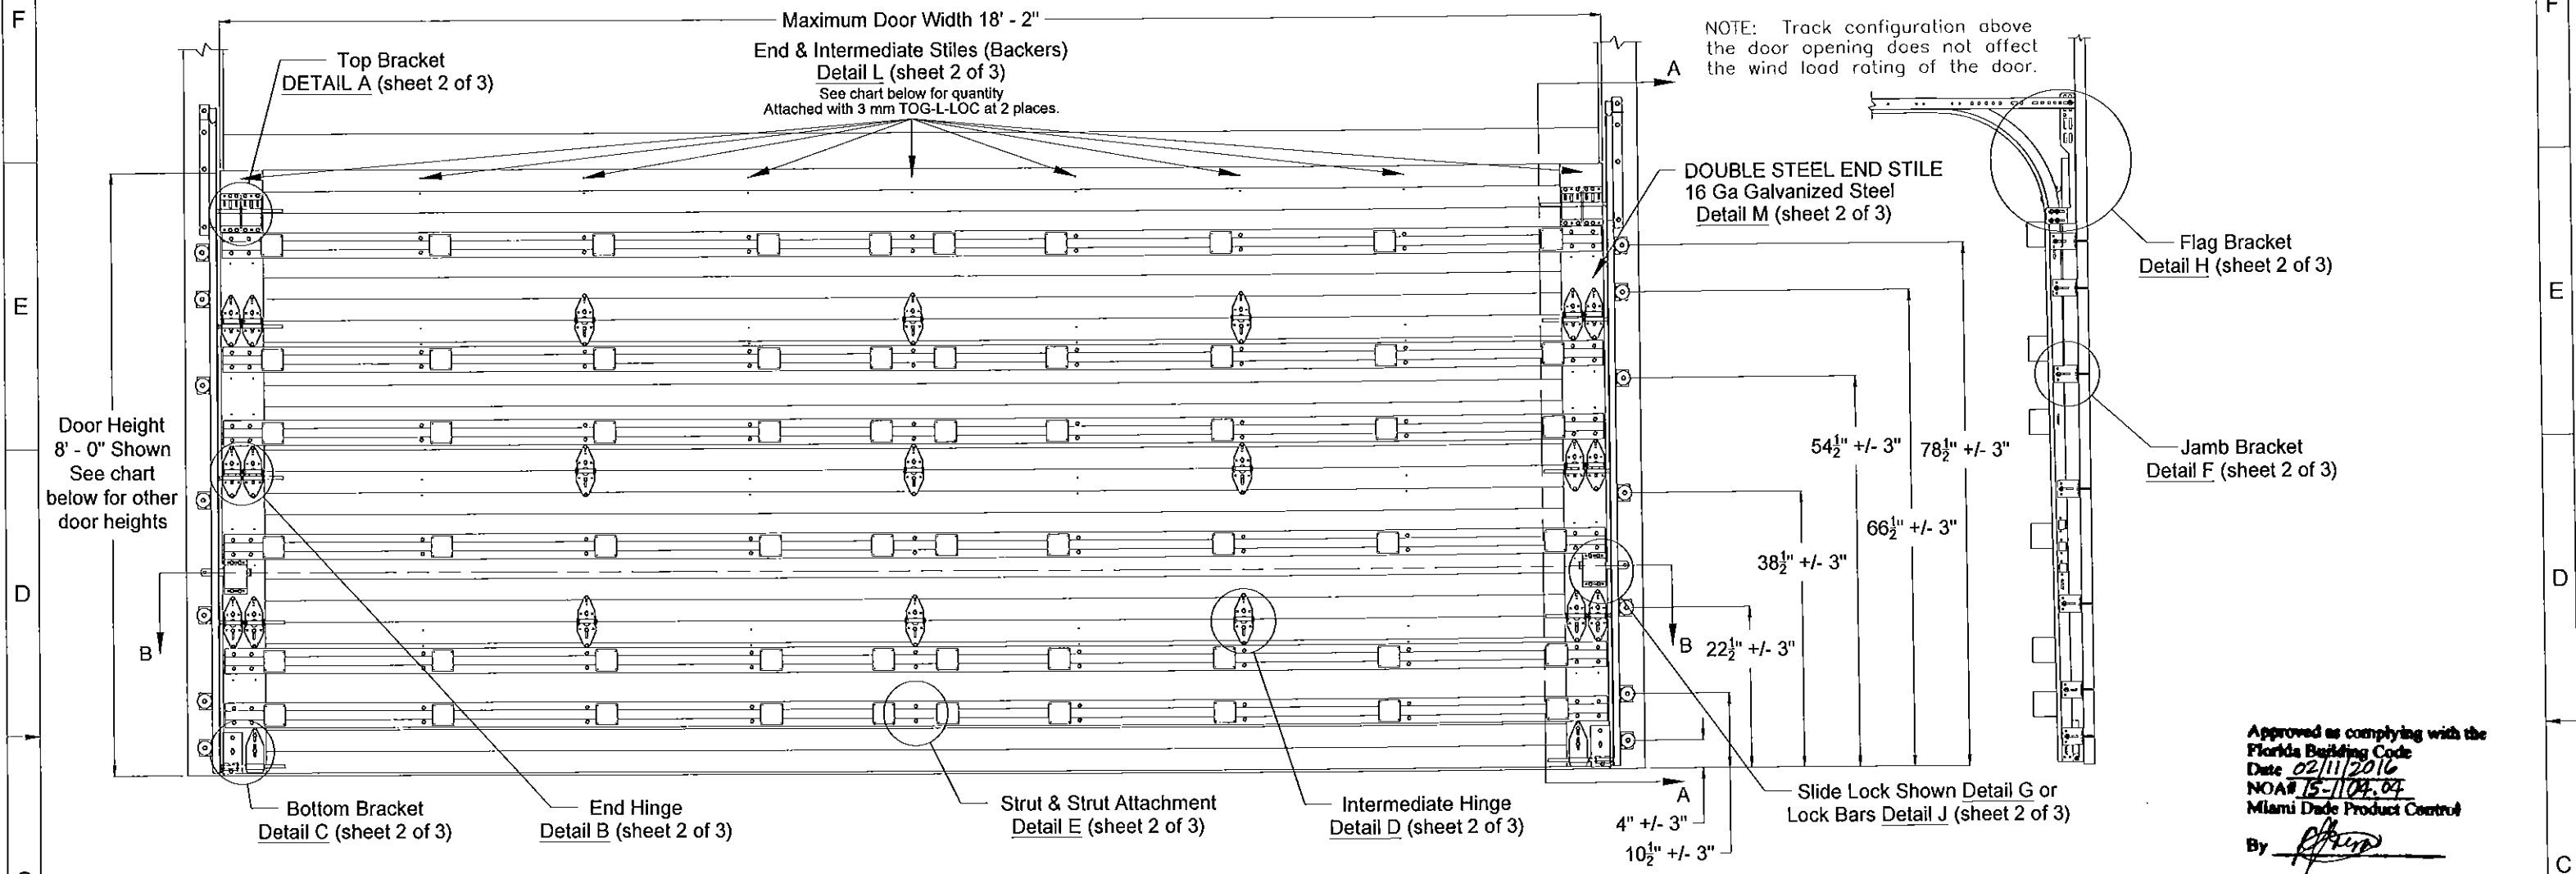

Approved as complying with the
Florida Building Code
Date 02/11/2016
NOA# 15-1104.04
Miami Dade Product Control

By *[Signature]*

This product has been tested per TAS202-94 for static air pressure.

This product has been tested per TAS201/203-94 for large missile impact and cyclic wind pressure.

			Model Number									
			HT_80 & 2_80 SERIES HT_81 & 2_81 SERIES HT_82 & 2_82 SERIES HT_90 & 2_90 SERIES		HT_60 & 2_60 SERIES HT_61 & 2_61 SERIES HT_63 & 2_63 SERIES HT_64 & 2_64 SERIES		HT_70 & 2_70 SERIES HT_71 & 2_71 SERIES HT_72 & 2_72 SERIES HT_73 & 2_73 SERIES HT_74 & 2_74 SERIES		HT_10 & 2_10 SERIES HT_12 & 2_12 SERIES HT_14 & 2_14 SERIES HT_16 & 2_16 SERIES HT_32 & 2_32 SERIES HT_33 & 2_33 SERIES			
Door Width	Design Pressures		End Backers	Center		Center		Center		Center		Impact Resistant
	+ psf	- psf		Stiles	Hinges	Stiles	Hinges	Stiles	Hinges	Stiles	Hinges	
16'-3" thru 18'-2"	45.0	-50.0	Double	7	3	7	3	7	3	7	3	YES

This product is available in narrower sizes with the same PSF and constructed as shown.

This product is designed and sold by PSF. The AHJ or Engineer of Record is responsible for determining the PSF required for any given site.

Jamb bracket quantities shown are for use with grade 2 or better southern pine jambs.

Supporting structural element designs are to be the responsibility of the professional of record for the building or structure for the loads listed on this drawing.

Door Height	Total No. of Sections	Total No. of Struts	Strut Configuration	Jamb Brkts/ Side
6'-0"	3	5	SEE SHEET 3 OF 3	5
6'-0"	4	6		5
6'-3"	4	6		5
6'-6"	4	6		6
6'-9"	4	6		6
7'-0"	4	6		6
7'-3"	4	6		6
7'-6"	4	6		7
7'-6"	5	8		7
7'-9"	4	6		7
7'-9"	5	8		7
8'-0"	4	6		7
8'-0"	5	8		7


Maximum section height is 24 in.


Maximum door height is 16 ft.

All doors, even those above the tested height, are available with jamb brackets or commercial full angle. The quantity and dimensional location of the jamb brackets/track clips and the jamb mounting shown above should be maintained.


NOTICE:

These drawings are a supplement to the installation instructions for a standard door and only covers those procedures that vary from standard door installation. If these specific procedures are not followed, the door may not perform as designed.

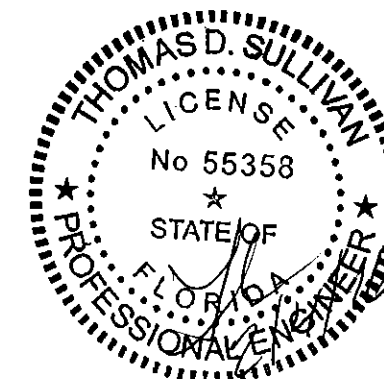


IMPACT RESISTANT 	This product has been evaluated for use in the High Velocity Hurricane Zone (HVHZ).		
	18'2" HT 600, 700, 2000 & 800 STEEL SERIES HVHZ WIND LOAD SECTIONAL DOOR DESIGN PRESSURE +45.0/-50.0 PSF		
320 Sycamore Wauseon, Ohio 43567 419-337-9900 © Copyright 2014	DRAWING NO.: WL-0600-0218-08-45-50M-D	REV.	
	DATE DRN: 1/8/15	DRAWN BY: MVS	
	MODEL(S): See Sheet 3		SHEET: 1 OF 3


REVISIONS				
REV.	ZONE	BY	DESCRIPTION	DATE

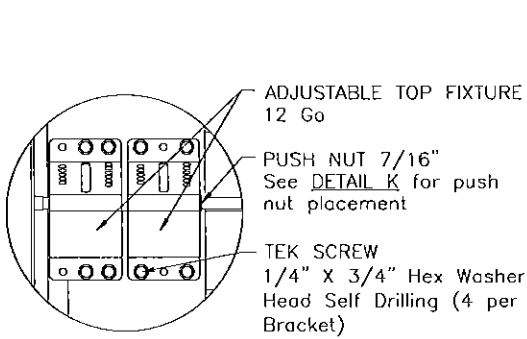


DETAIL A

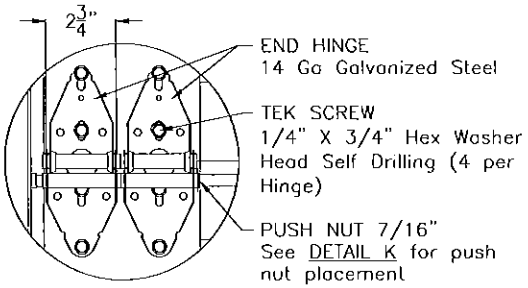

DETAIL B

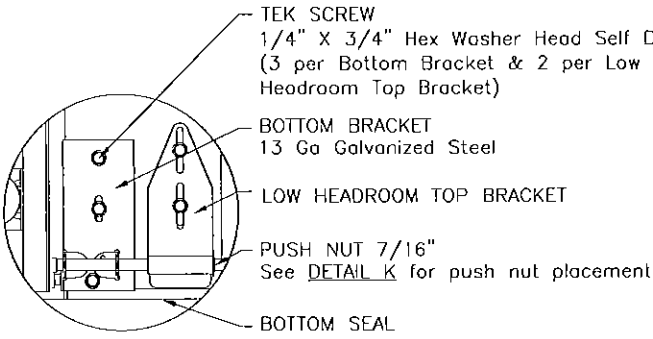


DETAIL C

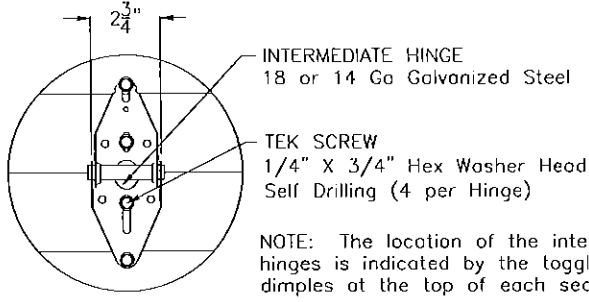


DETAIL D


NOTE: The location of the intermediate hinges is indicated by the toggle lock dimples at the top of each section.

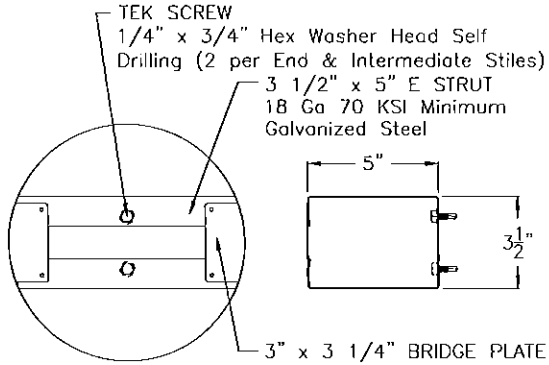


DETAIL E

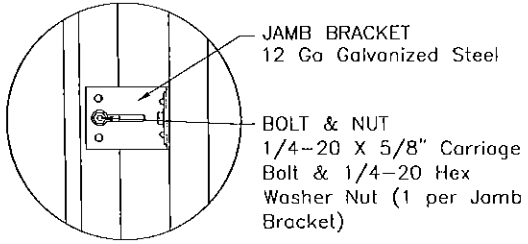

DETAIL F

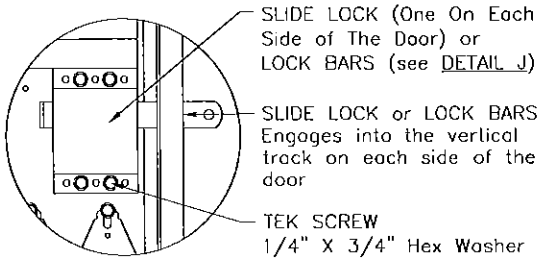


DETAIL G

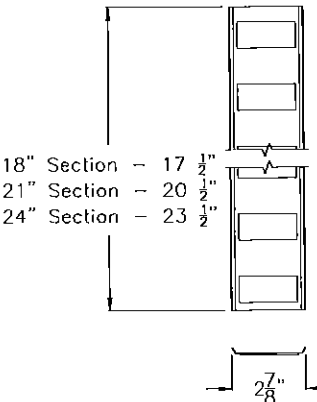


DETAIL L

MATERIAL: 20 GA CS Steel, G40 Min. Hot Dipped Galvanized

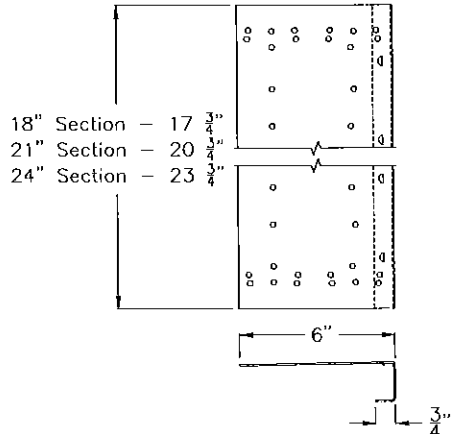


DETAIL M

MATERIAL: 16 GA CS Steel, G40+ Min. Hot Dipped Galvanized

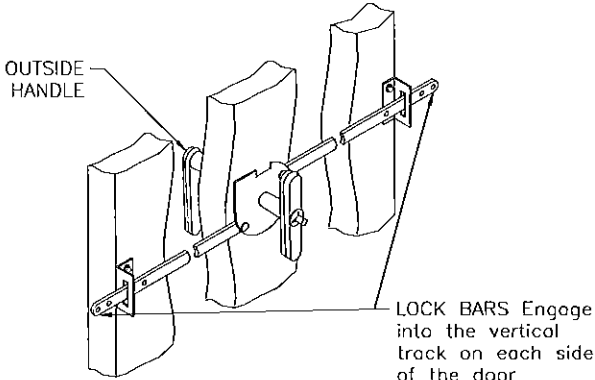


DETAIL J

Alternate Lock Configuration

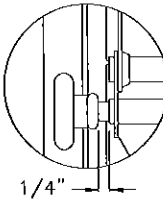


DETAIL K

There should be a space of 1/4" between the roller hub and the outside edge of the roller holder which is set by the push nut.

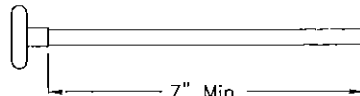



ROLLER

2" Diameter Nominal Ten Ball Nylon w/Hardened Shaft or Ten Ball Steel w/Hardened Shaft with a Minimum Workable Shaft Length Shown.

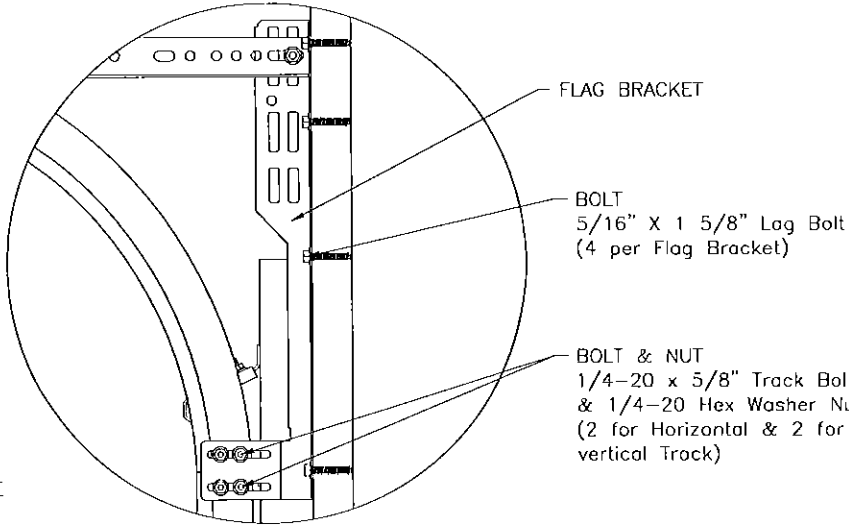


DETAIL H

Approved as complying with the Florida Building Code
Date 02/11/2016
NOA# 15-1104-04
Miami Dade Product Control
By [Signature]

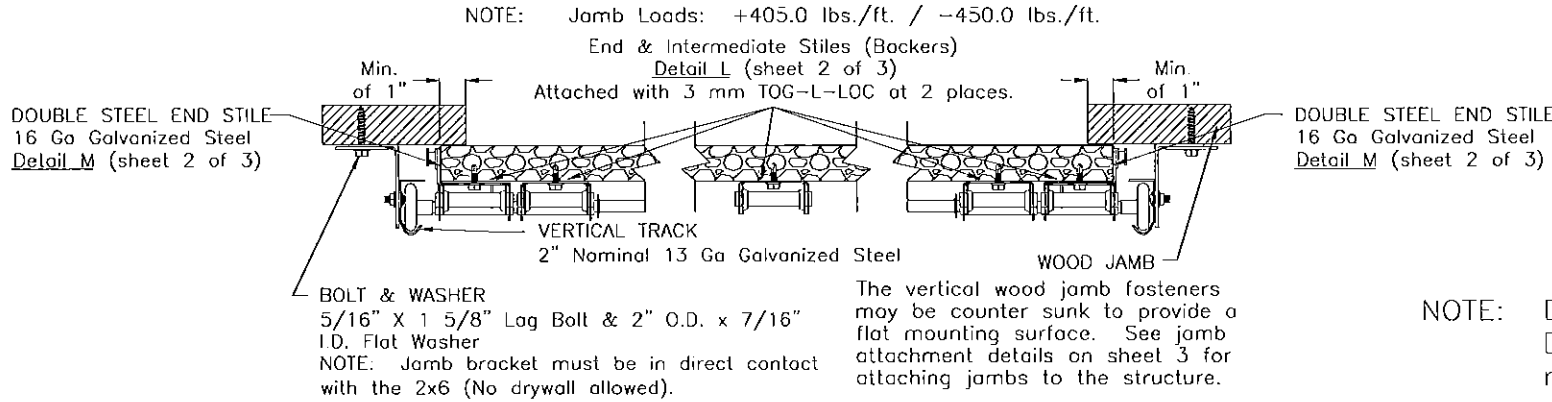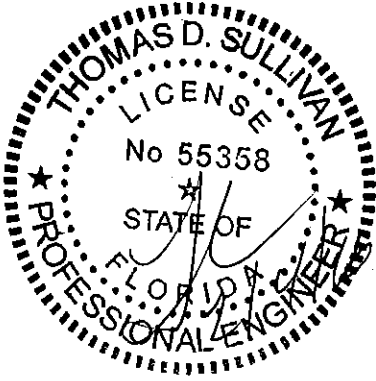


SECTION B-B

NOTE: Details on some views omitted for clarity. Double end stiles and end hardware may be required on wider or heavier doors.

IMPACT RESISTANT  A Notzger Company	This product has been evaluated for use in the High Velocity Hurricane Zone (HVHZ).		
	18'2" HT 600, 700, 2000 & 800 STEEL SERIES HVHZ WIND LOAD SECTIONAL DOOR DESIGN PRESSURE +45.0/-50.0 PSF		
320 Sycamore Wauseon, Ohio 43567 419-337-9900 © Copyright 2014	DRAWING NO.: WL-0600-0218-08-45-50M-D	REV.	
	DATE DRN: 1/8/15	DRAWN BY: MVS	
	MODEL(S): See Sheet 3		SHEET: 2 OF 3

Complies with the FBC 5th Edition, (2014)



REVISIONS				
REV.	ZONE	BY	DESCRIPTION	DATE

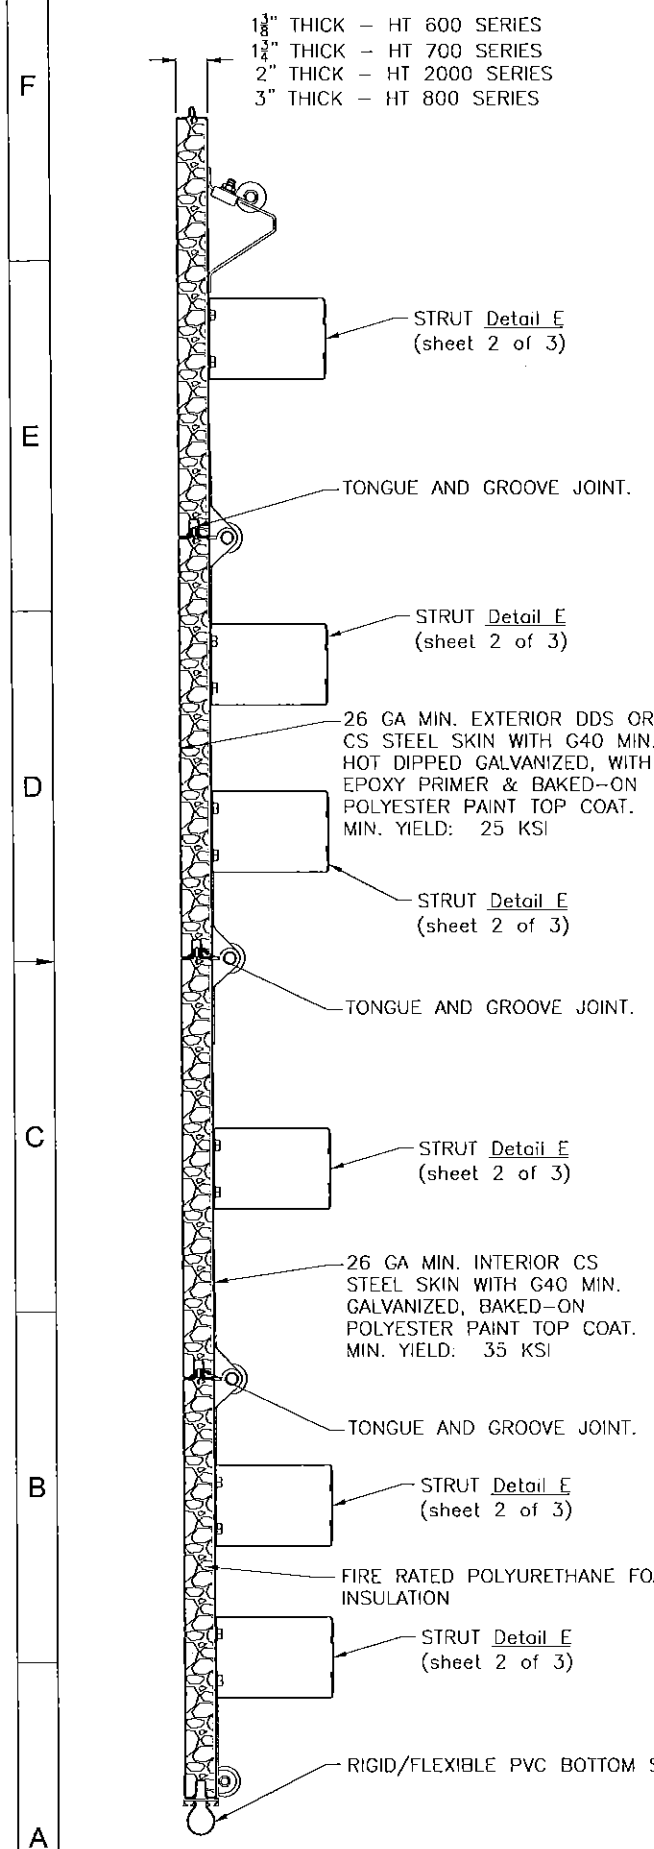

SECTION A-A

Building Structure	Fastener Type	Minimum Embedment	Minimum Edge Distance	Minimum on Center Spacing	Maximum on Center Spacing	Allowable Tension Load
Min. 3515 PSI Concrete	Ultracon 5/16" w/ 1" OD washer	2"	3 1/8"	5"	12"	835 #
Min. 4000 PSI Concrete	Tapcon 1/4" w/ 1" OD washer	1 3/4"	2 1/2"	3"	12"	594 #
Southern Pine (G = 0.55)	3/8" Lag w/ 1 1/8" OD washer	2"	1 1/2"	4"	12"	845 #
Spruce Pine Fir (G = 0.42)	3/8" Lag w/ 1 1/8" OD washer	2 1/2"	2"	4"	12"	705 #


NOTE: 2X6 mounted to the wall must be Southern Pine Grade 2 or better.

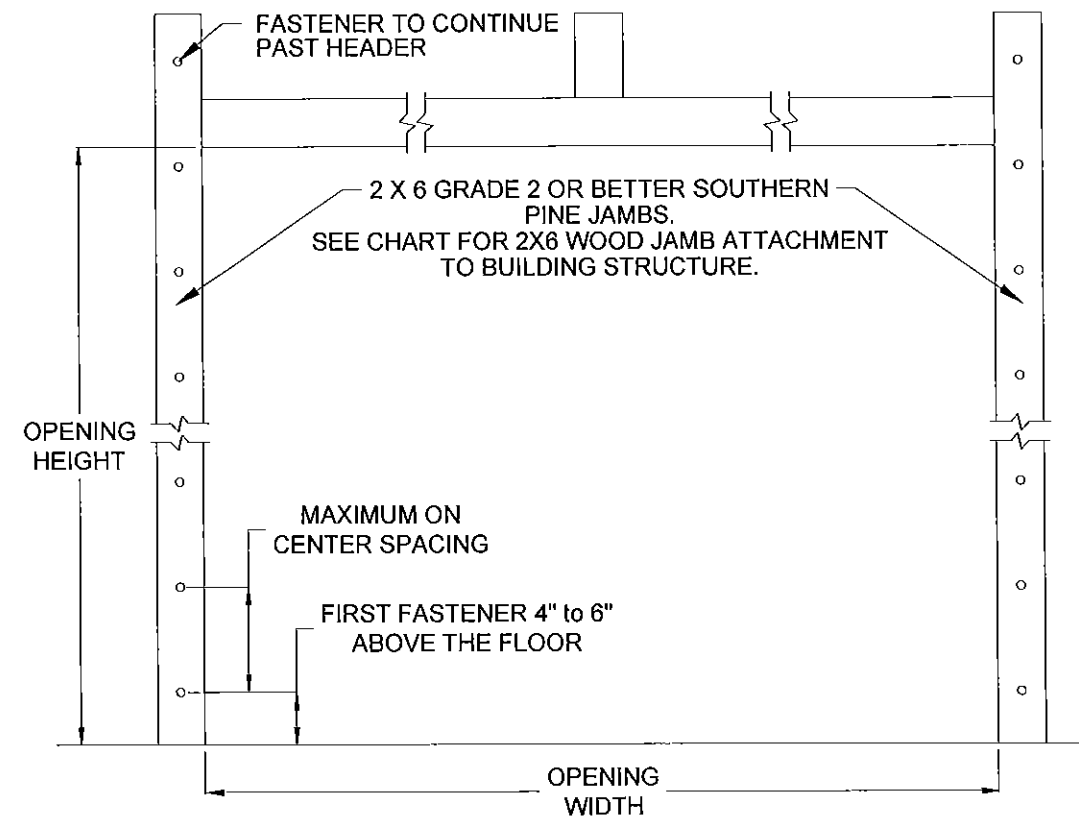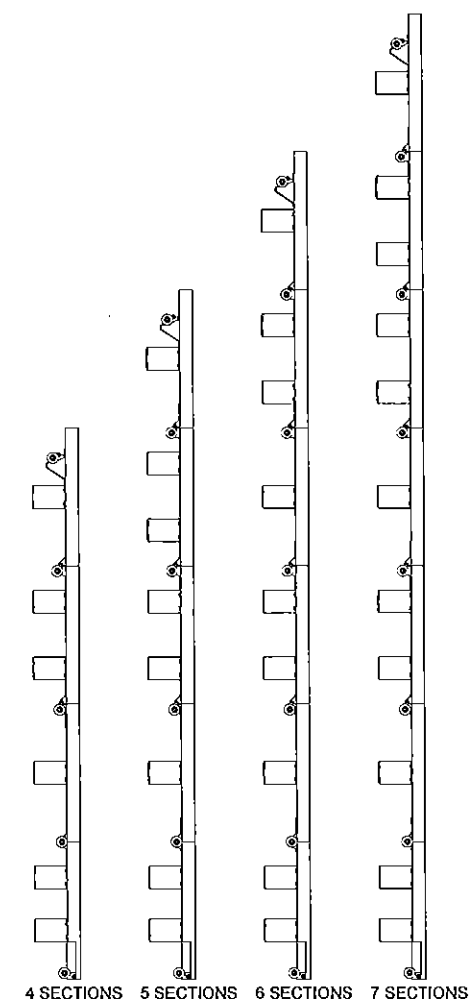


MODEL NUMBERS

MODEL NUMBERS AVAILABLE	
HT _14 & 2_14 SERIES	
HT _16 & 2_16 SERIES	
HT _32 & 2_32 SERIES	
HT _33 & 2_33 SERIES	
HT _10 & 2_10SERIES	
HT _12 & 2_12 SERIES	
HT _60 & 2_60 SERIES	
HT _61 & 2_61 SERIES	
HT _63 & 2_63 SERIES	
HT _64 & 2_64 SERIES	
HT _70 & 2_70 SERIES	
HT _71 & 2_71 SERIES	
HT _72 & 2_72 SERIES	
HT _73 & 2_73 SERIES	
HT _74 & 2_74 SERIES	
HT _80 & 2_80 SERIES	
HT _81 & 2_81 SERIES	
HT _82 & 2_82 SERIES	
HT _90 & 2_90 SERIES	

Approved as complying with the
Florida Building Code
Date 02/11/2016
NOA# 15-1104.04
Miami Dade Product Control
By [Signature]

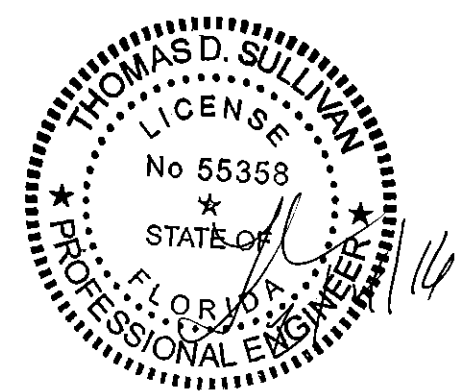

IMPACT RESISTANT  A Notzger Company	This product has been evaluated for use in the High Velocity Hurricane Zone (HVHZ).		
	18'2" HT 600, 700, 2000 & 800 STEEL SERIES HVHZ WIND LOAD SECTIONAL DOOR DESIGN PRESSURE +45.0/-50.0 PSF		
320 Sycamore Wauseon, Ohio 43567 419-337-9900 © Copyright 2014	DRAWING NO.: WL-0600-0218-08-45-50M-D	DATE DRN: 1/8/15	REV. REV.
	DRAWN BY: MVS	MODEL(S): See Sheet 3	SHEET: 3 OF 3